


M0603
 Soundings
 Overall length=62.0'

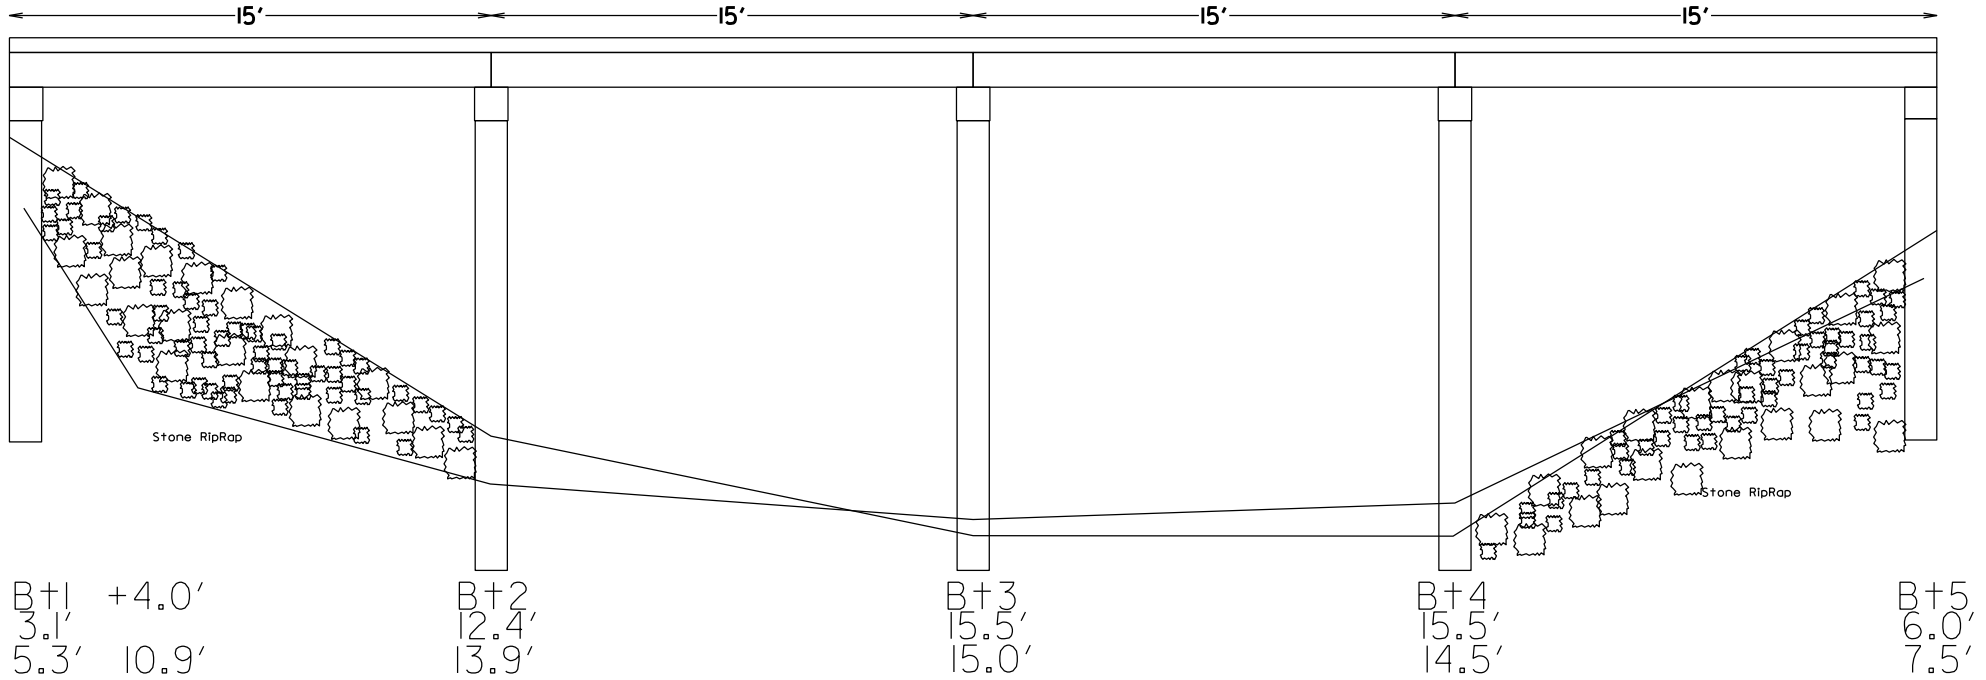

Channel sounded top of deck, left upstream side.

Red lines & readings: 01-18-2011

Green lines & readings: 03-07-2003

Stone Riprap placed under Spans 1 & 4 in 2010